




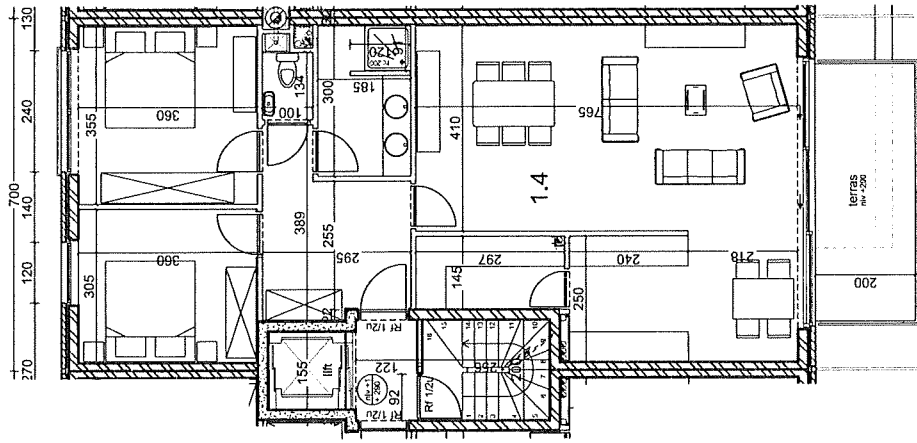


RESIDENTIE POLDERWIND IV
VUURKRUISERSSTRAAT - 9400 NINOVE
AS BUILT PLAN - APP. 1.4

schaal 1/100

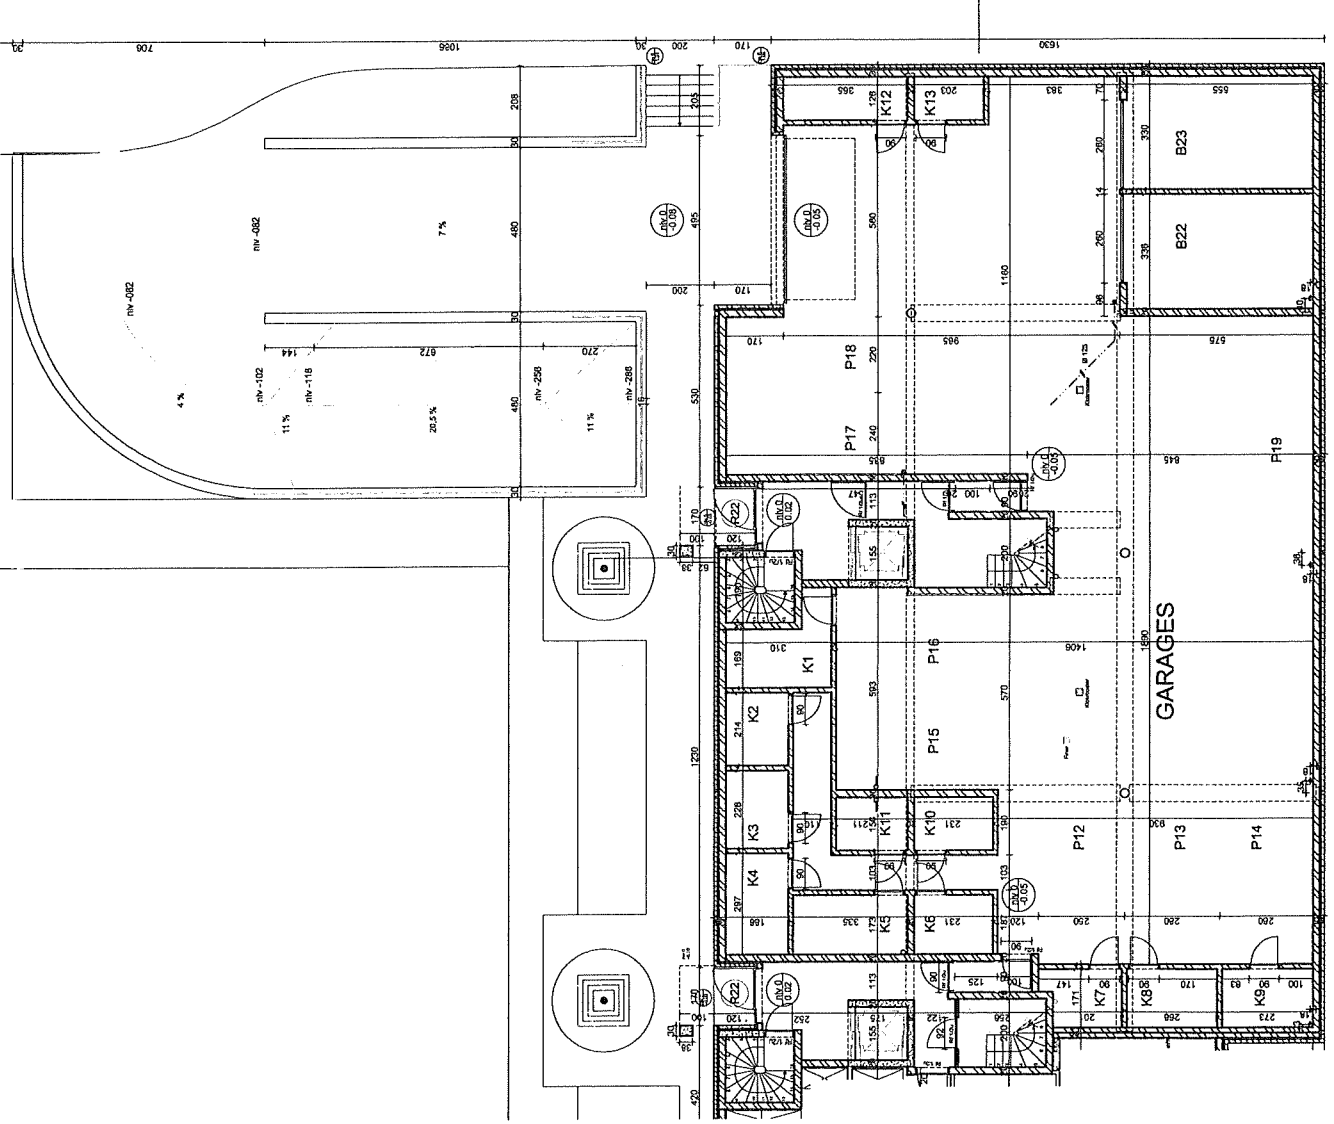


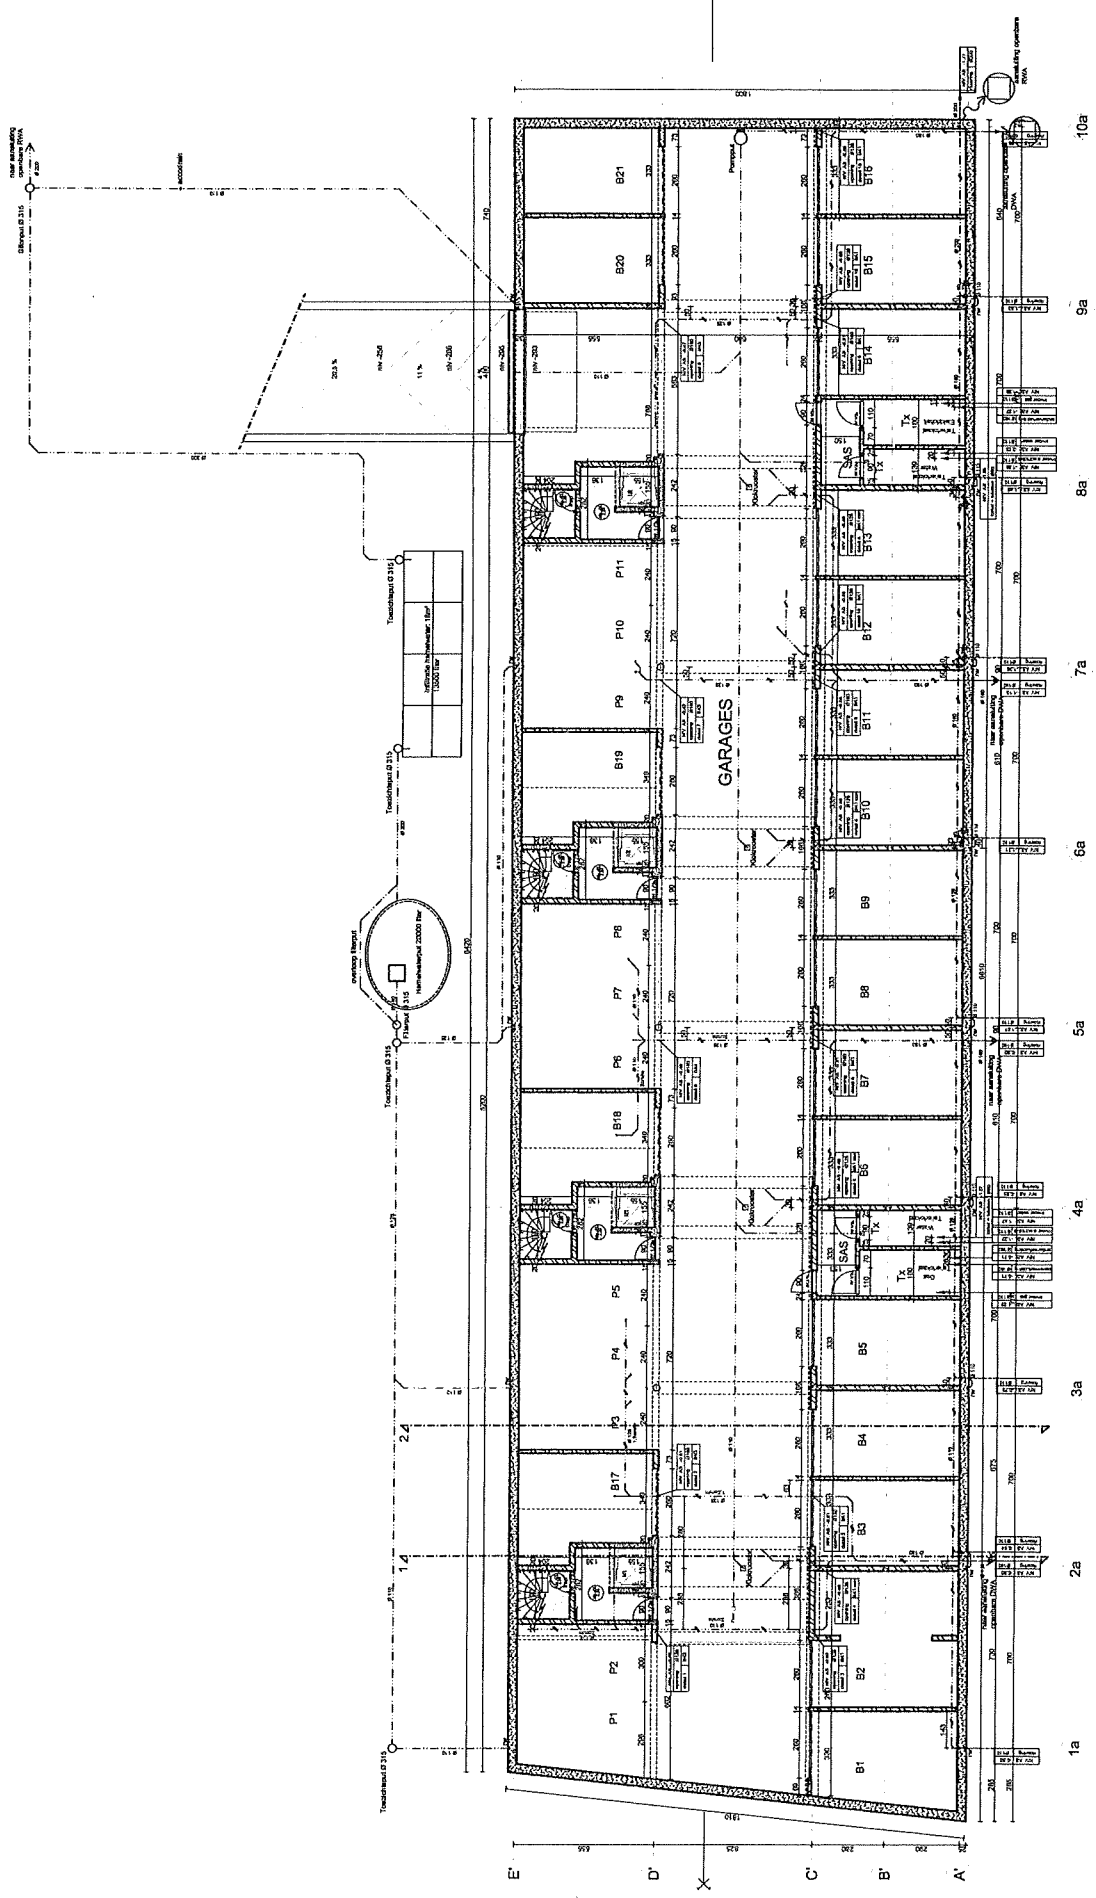


RESIDENTIE POLDERWIND IV
 VUURKRUISERSSTRAAT - 9400 NINOVE
 AS BUILT PLAN - gemeenschappelijke delen - kelderplan

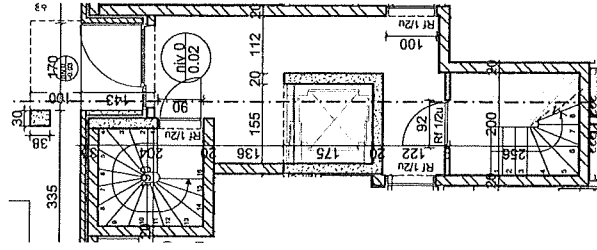


app.: 0.1 - 0.2 - 1.1 - 1.2 -
2.1 - 2.2 - 3.1 - 3.2 - 4.1 - 4.2

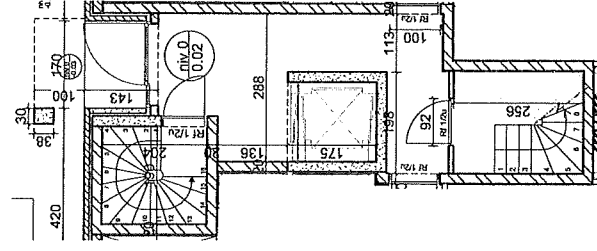

app.: 0.3 - 0.4 - 1.3 - 1.4 -
2.3 - 2.4 - 3.3 - 3.4 - 4.3 - 4.4

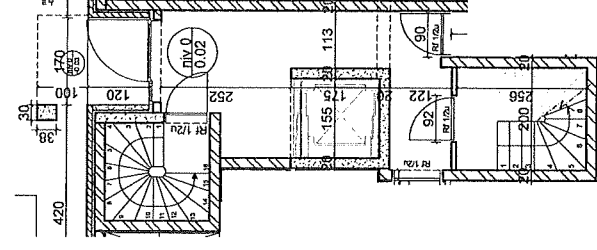

app. : 0.5 - 1.5 - 1.6 -
2.5 - 2.6 - 3.5 - 3.6 - 4.5 - 4.6

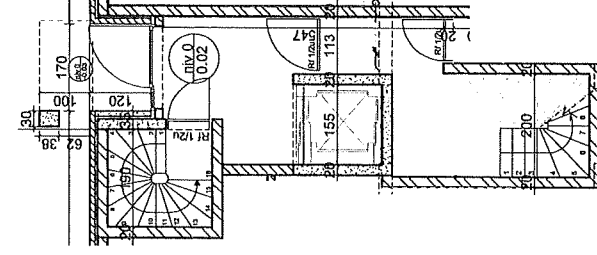

app.: 1.7 - 1.8 - 1.9 - 2.7 - 2.8
3.7 - 3.8 - 3.9 - 4.7 - 4.8

RESIDENTIE POLDERWIND IV
VUURKRUISERSSTRAAT - 9400 NINOVE
AS BUILT PLAN - gemeenschappelijke delen - gelijkvloers